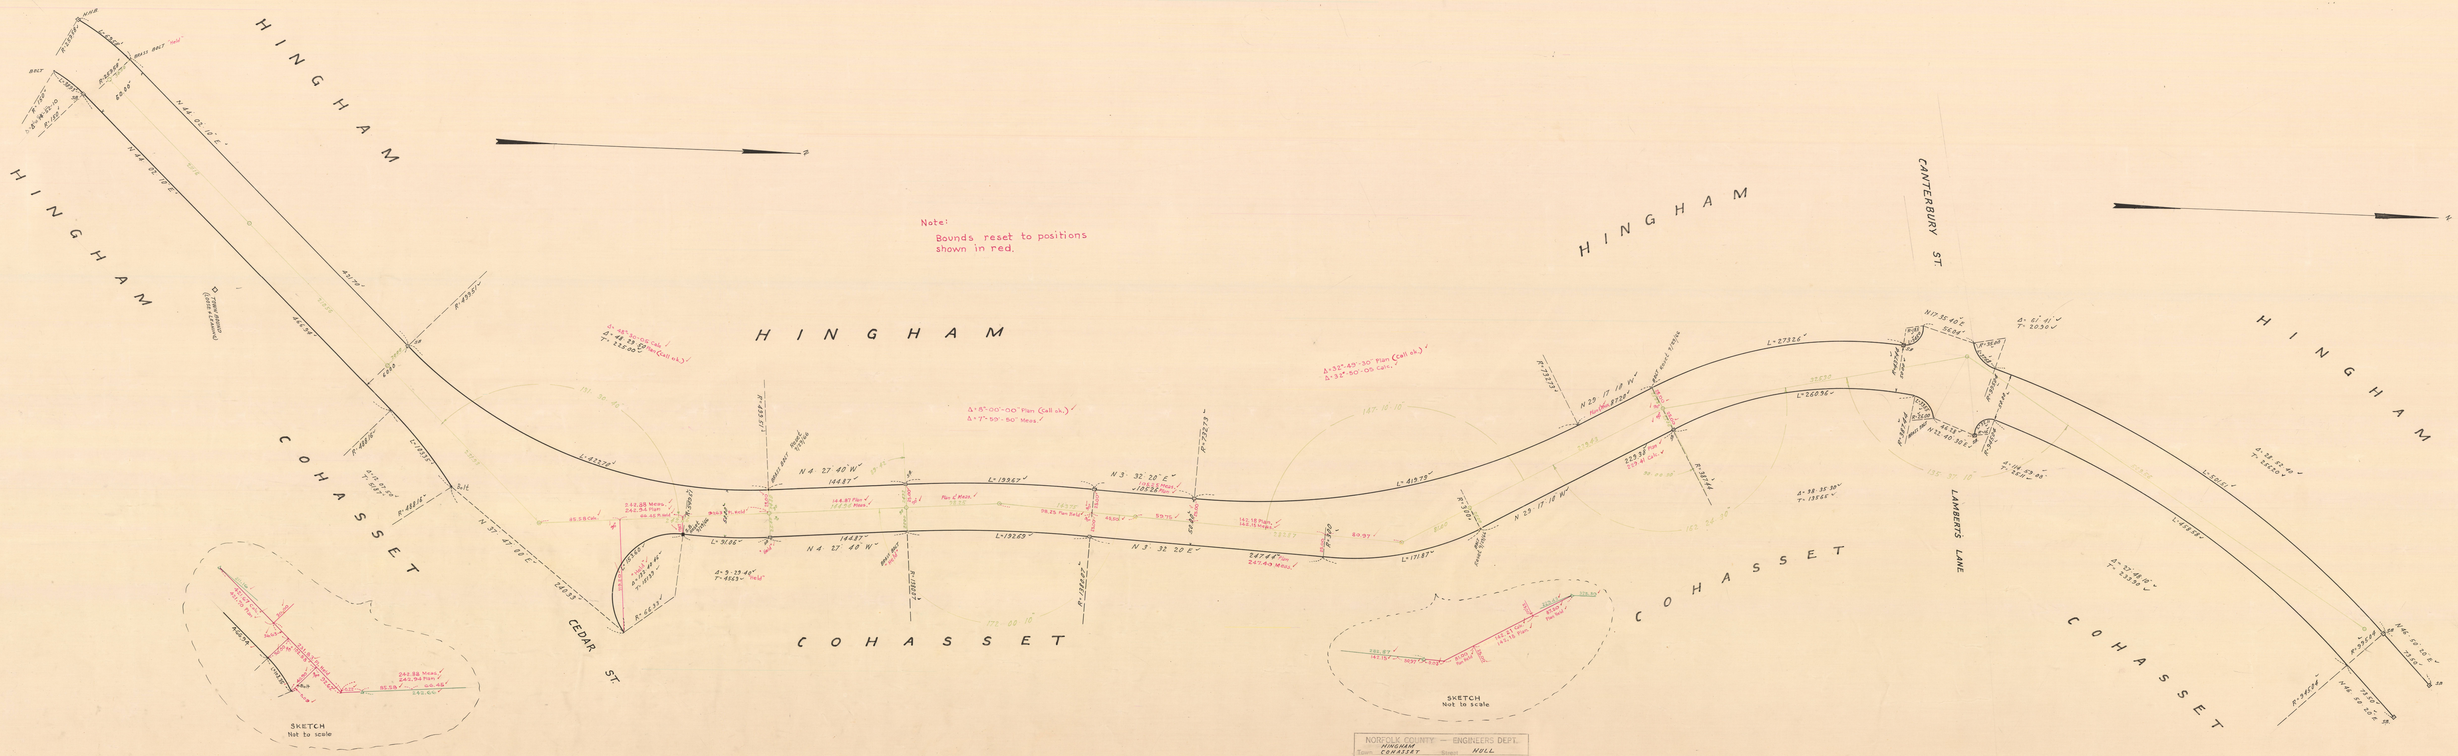
HINGHAM
HINGHAM
HINGHAM
HINGHAM
HINGHAM
COHASSET
COHASSET
COHASSET
COHASSET
CEDAR ST
CANTERBURY ST
LAMBERT'S LANE
Note:
Bounds reset to positions shown in red.
SKETCH
Not to scale
SKETCH
Not to scale
NORFOLK COUNTY — ENGINEERS DEPT.
Town HINGHAM COHASSET
Sheet NULL
Date AUG 1966
Scale 1" = 40'
Field Book 166 166
Hours Book
Calc. Book 109
Envelope